


BASEMENT 1,367 - 117 Mech. = 1,250 sq ft

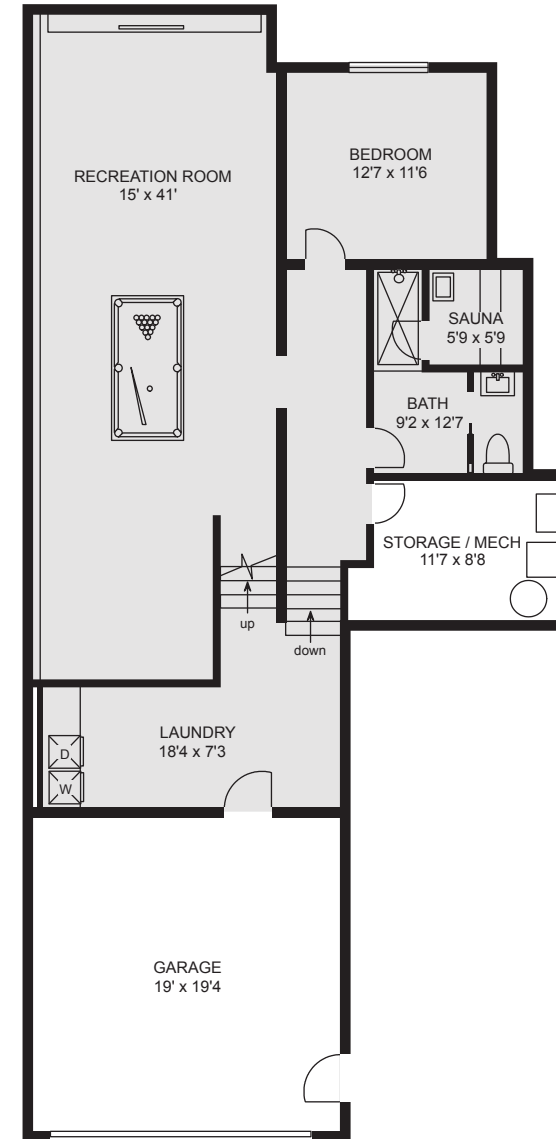

Main	1,275 sq ft
Below	1,472 sq ft
Basement	1,250 sq ft
TOTAL	3,997 sq ft
Mechanical	117 sq ft
Garage	405 sq ft
GROSS	4519 sq ft

plus 620 sq ft Deck, Patios and Entry

*Area includes 6" of exterior walls

These As-Built plans are intended to be used for marketing purposes and are indicative only. Although all due care is taken in the preparation of these drawings all details and measurements should be deemed approximate and used for informational purposes only. Responsibility for any errors and omissions is expressly denied. Inside Advantage makes no representations regarding the legality of the spaces illustrated. All interested parties should make their own enquires. E&OE